
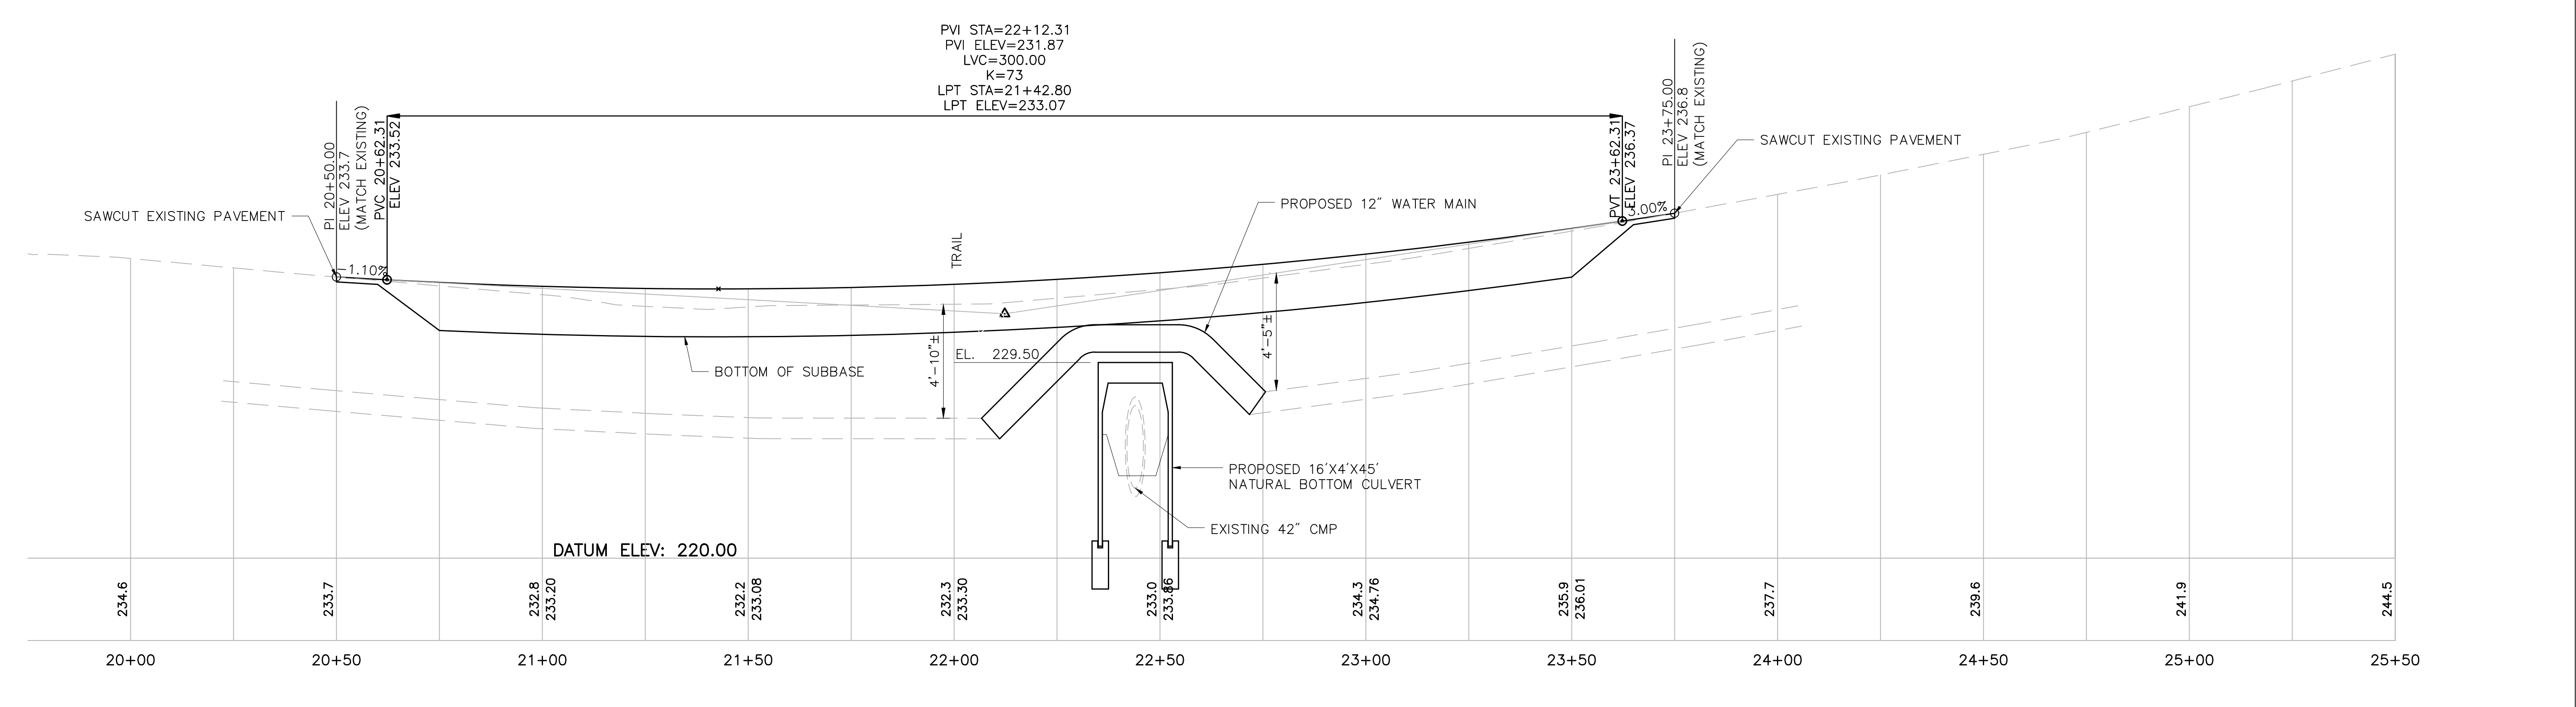


REVISIONS AFTER PROPOSAL	DESCRIPTION	STATION	DATE	NUMBER

PROJECT MANAGER: G. GOODRICH	DATE: FEBRUARY 15, 2018
DESIGNED BY: K. DURSO, J. WHITMORE, M. VEROSTICK	DATE: FEBRUARY 15, 2018
DRAWN BY: K. WENTWORTH, C. CILLEY	DATE: FEBRUARY 15, 2018
AS BUILT DETAILS	DATE:

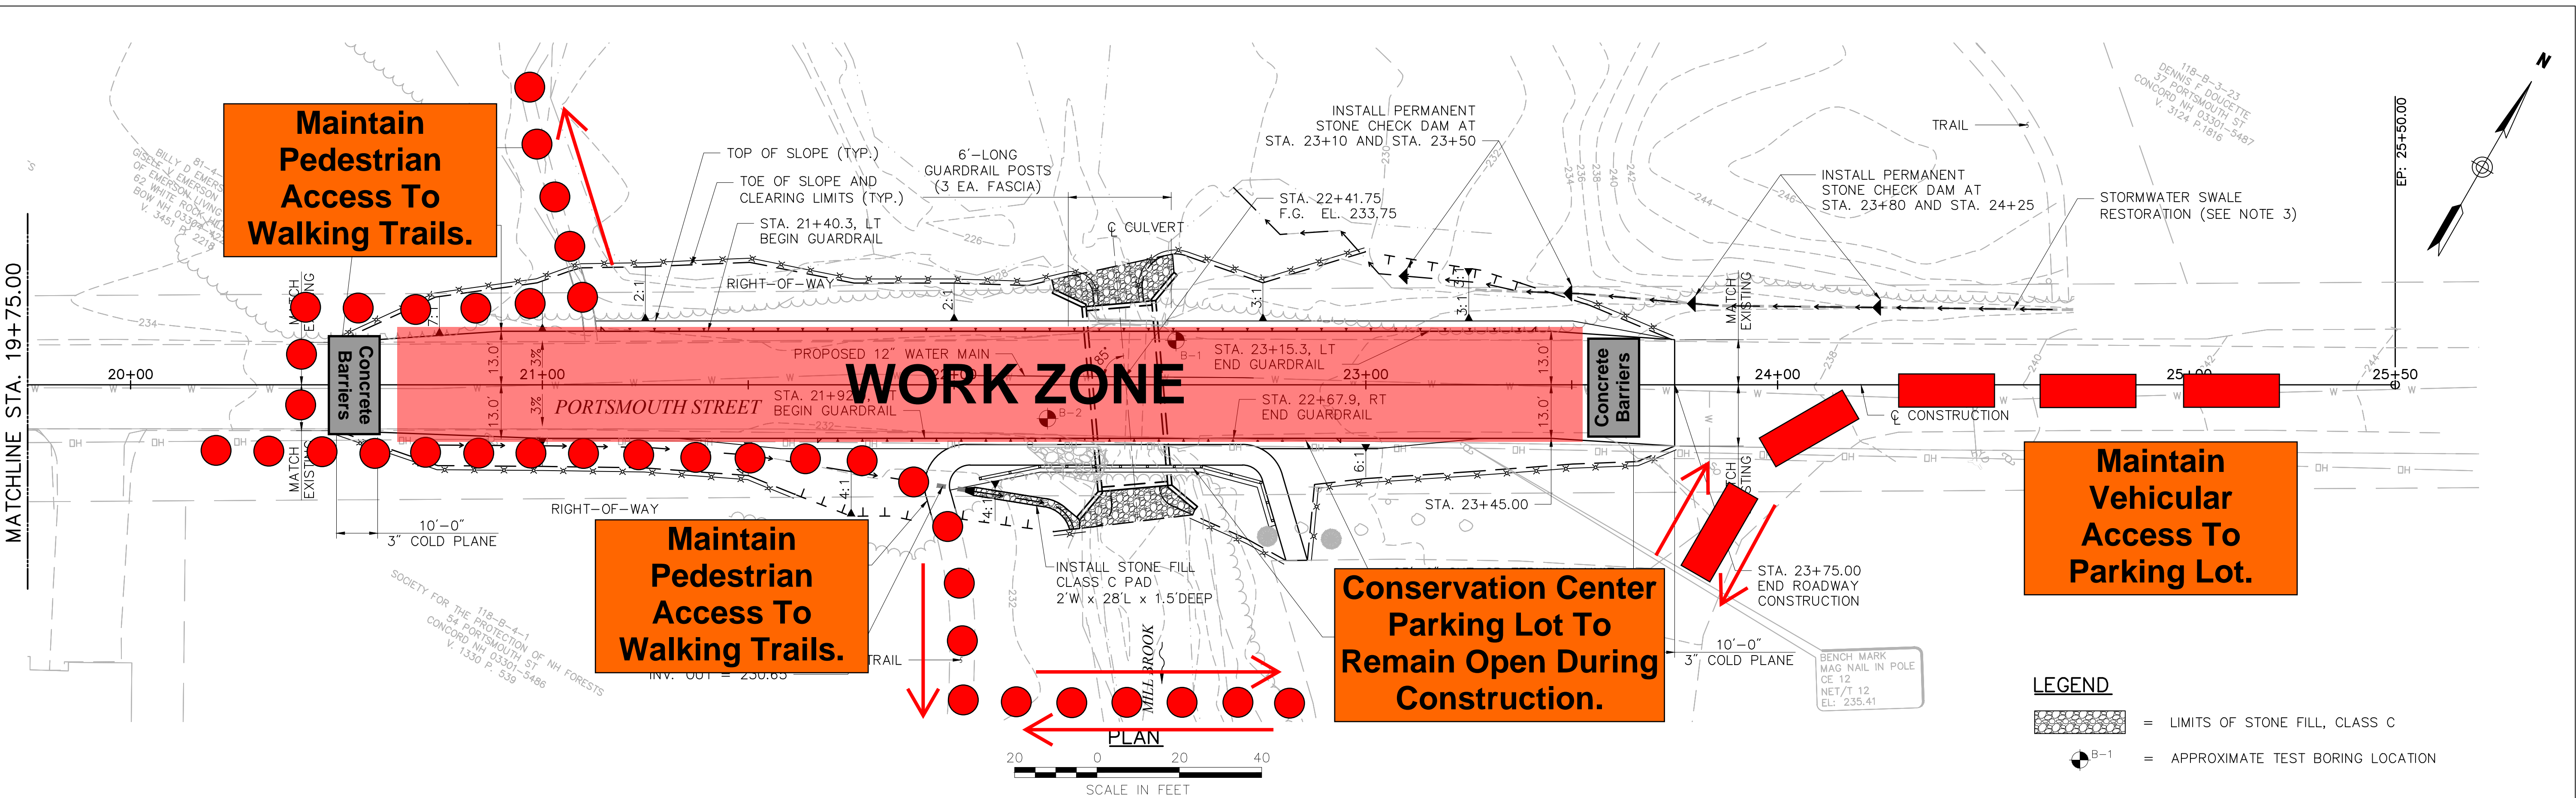

NOTES

- SEE WETLAND IMPACT PLAN FOR LIMITS OF EXISTING SEDIMENT REMOVAL.
- TEST BORINGS SHOWN WERE ADVANCED ON MARCH 27, 2017 UNDER THE DIRECTION OF TERRACON WITH EQUIPMENT OWNED AND OPERATED BY TERRACON OF MANCHESTER, NH. SEE PROJECT CONTRACT BOOK FOR GEOTECHNICAL REPORT, PREPARED BY TERRACON, DATED APRIL 12, 2017, FOR BORING LOGS.
- SEE NOTES SHEET FOR STORMWATER SWALE RESTORATION NOTES AND DETAILS.



DATE PLOTTED FEBRUARY 15, 2018		VHB PROJECT NO. 52430.03		DRAWING 52430.03_PLAN02		STATE PROJECT NO. -		SHEET NO. 4		TOTAL SHEETS 8	
-----------------------------------	--	-----------------------------	--	----------------------------	--	------------------------	--	----------------	--	-------------------	--

CITY OF CONCORD, NEW HAMPSHIRE
PORTSMOUTH STREET CULVERT REPLACEMENT

ROADWAY PLAN AND PROFILE